


A 105
CANTOR FITZGERALD
A1.1

TAA#941154
5/1/95

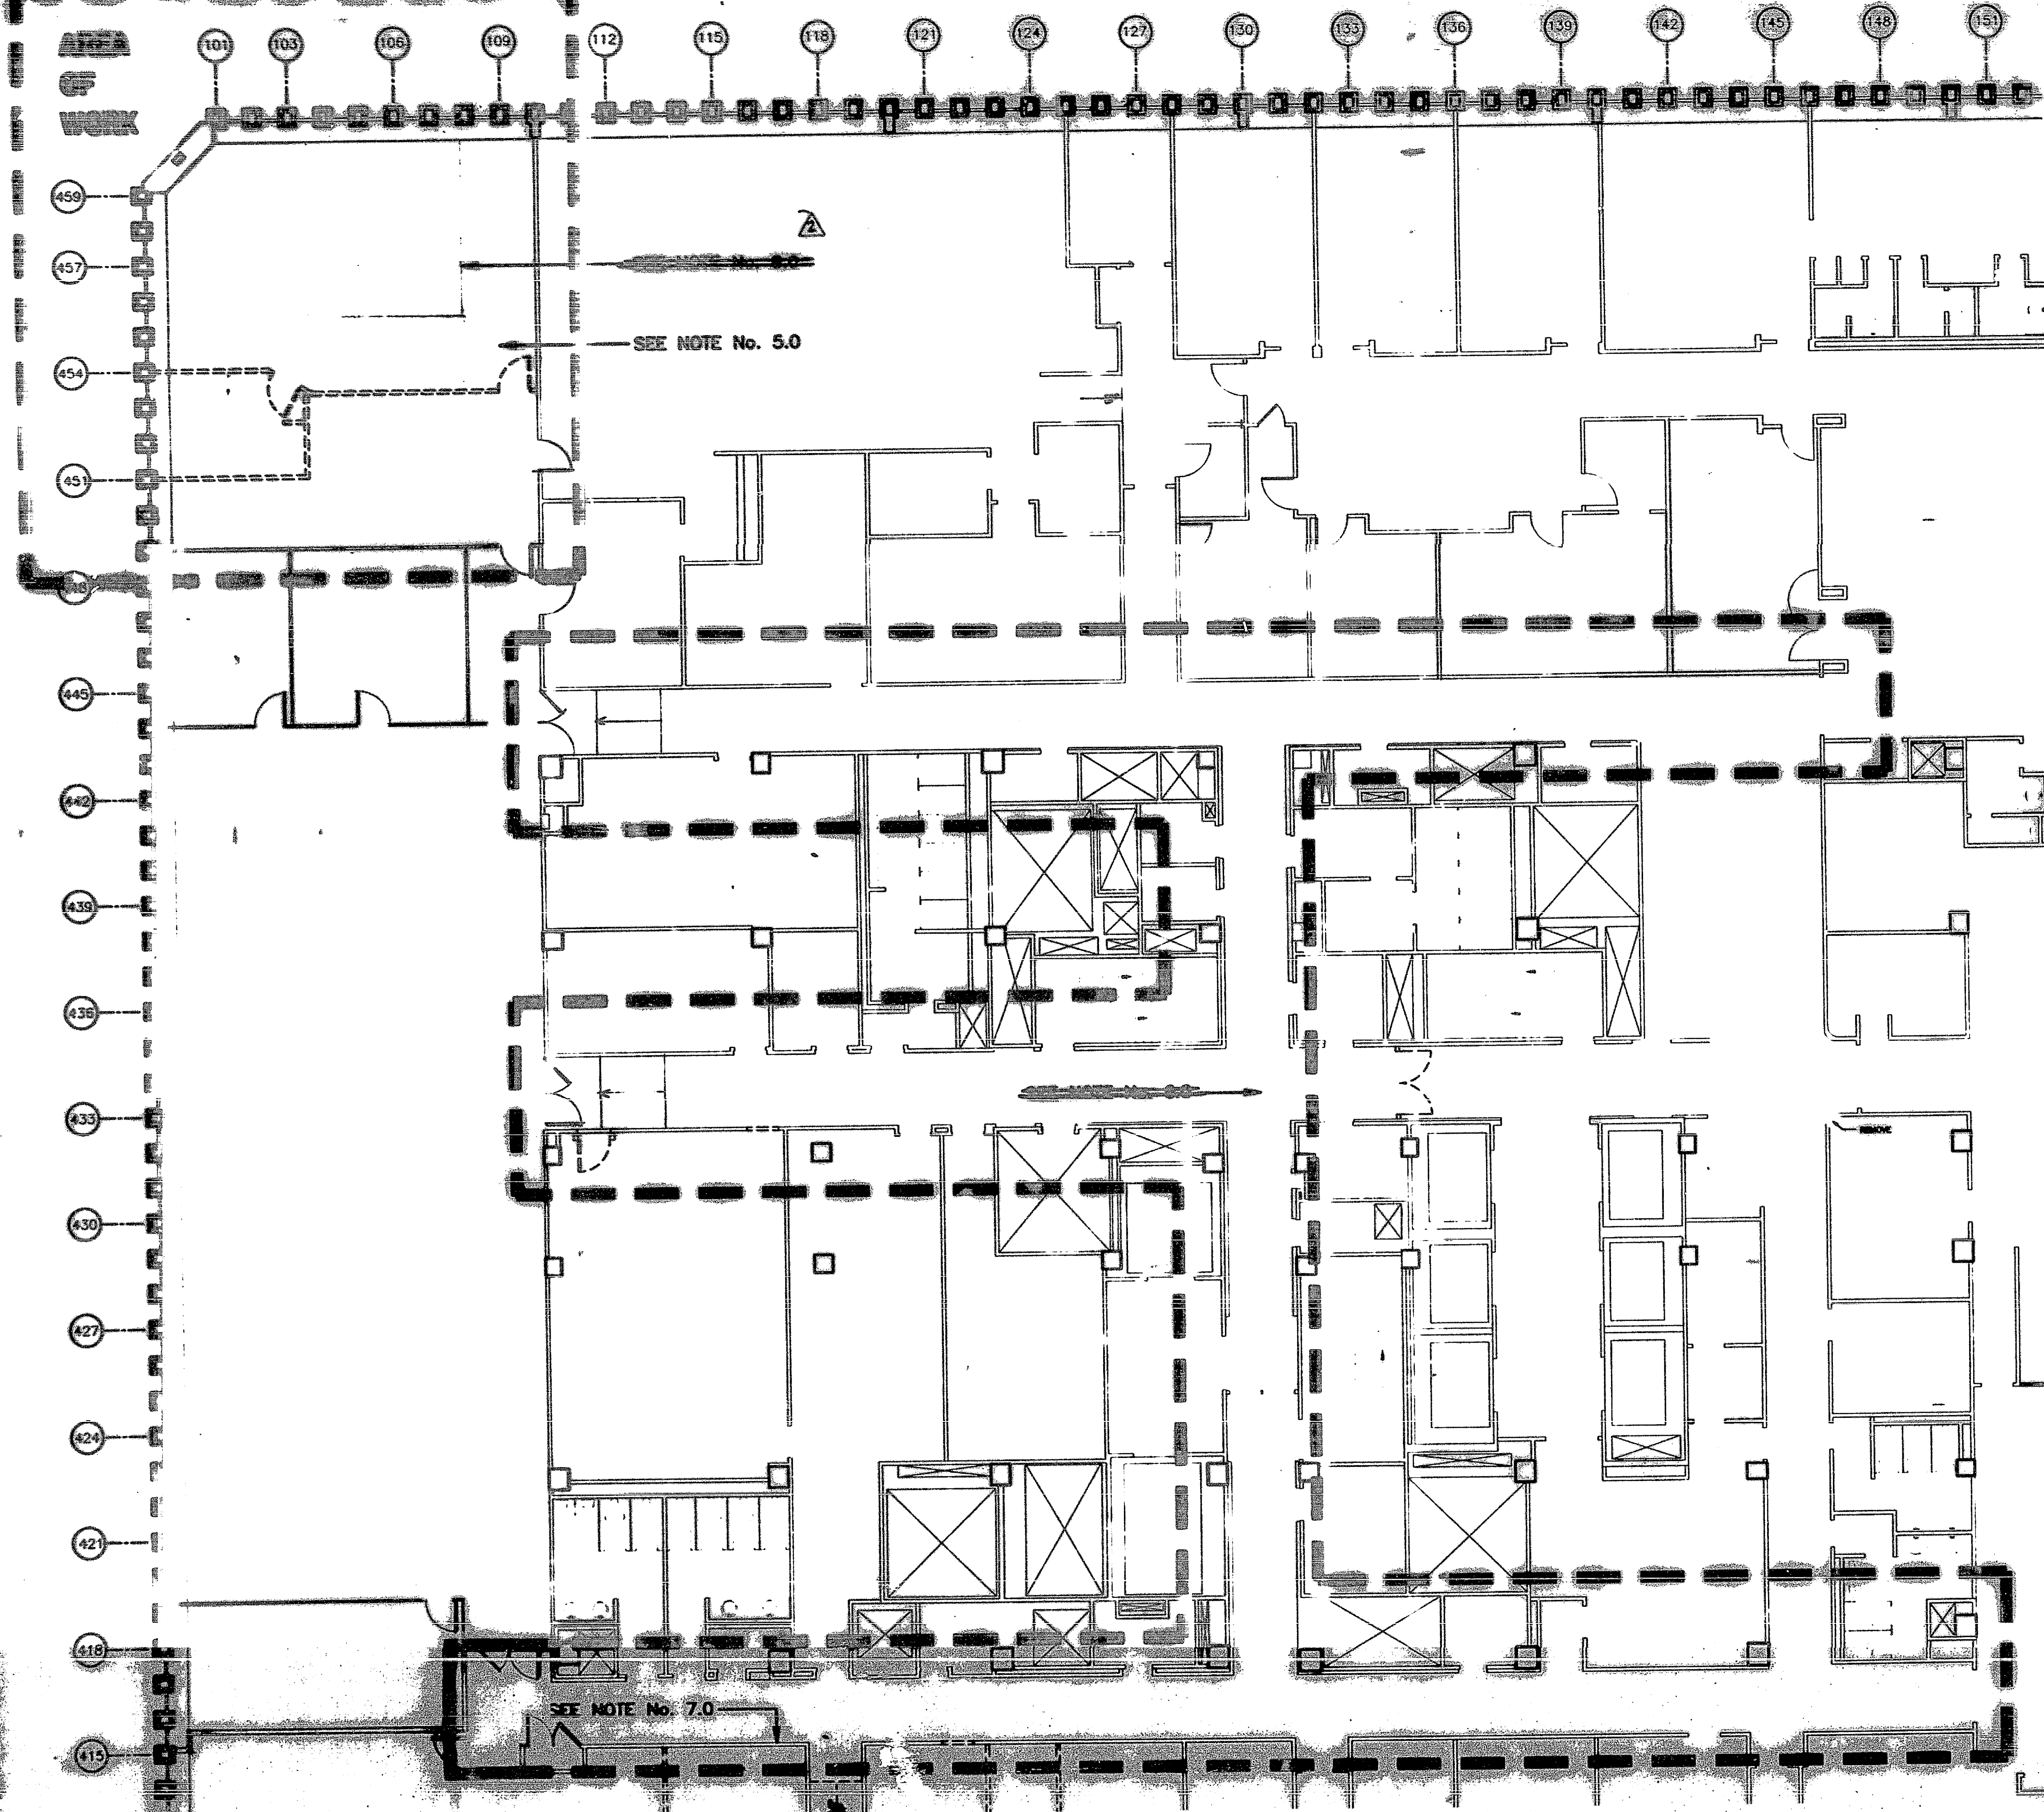


- NOTES:**
1. SEE 'B' DEMOLITION AND PATCHING NOTES, SHEET A3.1
 2. N/A
 3. REMOVE RAISED FLOOR IN ALL AREAS AS REQ'D BY ELECTRICAL CONTRACTORS AND SAVE FOR REUSE
 4. PROVIDE DUST PROOF ENCLOSURES AT ALL POINTS OF ACCESS WITH CORRIDORS, TYPICAL
 5. REMOVE EXISTING DOORS, FRAMES, ENCLOSURES, & CEILINGS. CEILING BLACKIRON TO REMAIN FOR RE-USE. REGARDING REMOVAL OR RE-USE OF DUCTWORK, SEE MECHANICAL DRAWINGS.
 6. REMOVE EXISTING OVERHEAD TRUSS ENCLAVING DUCTWORK
 7. EXISTING CEILING TO REMAIN. REMOVE 4 EXISTING WALL SCONCES AS INDICATED ON ELEVATIONS.
 8. EXISTING RAISED FLOOR IS TO REMAIN AND TO BE EXPANDED

- LEGEND:**
- EXISTING PARTITION TO REMAIN
 - - - EXISTING PARTITION TO BE REMOVED

REMOVAL AND DISPOSAL OF MATERIAL

1. CONTRACTOR SHALL EXERCISE EXTREME CARE IN REMOVAL OF ALL EXISTING CONSTRUCTION SO AS NOT TO DAMAGE CONSTRUCTION TO REMAIN.
2. THE REMOVAL AS DESCRIBED HEREIN SHALL BE ACCOMPLISHED WITHOUT STORING EXCESSIVE QUANTITIES OF ANY MATERIALS, RUBBISH, DIRT, DEBRIS OR WASTE OF ANY SORT RESULTING FROM THE REMOVAL OPERATIONS ON THE FLOOR.
3. ALL DEBRIS SHALL BE REMOVED FROM THE CONSTRUCTION SITE DAILY. HOWEVER, IT SHALL BE THE CONTRACTOR'S RESPONSIBILITY TO ADVISE THE PORT AUTHORITY WHEN HE REQUIRES CONTAINERS. THE CONTRACTOR SHALL LOAD THESE CONTAINERS WHICH WILL BE AT A CENTRAL LOCATION ON THE FLOOR. THE AUTHORITY SHALL REMOVE THE CONTAINERS AND THE CONTRACTOR SHALL BE RESPONSIBLE FOR PAYING THE AUTHORITY FOR SUCH RUBBISH REMOVAL.
4. THE CONTRACTOR SHALL PROVIDE ALL TEMPORARY DUST PROOF ENCLOSURES TO THE SATISFACTION OF THE ARCHITECT TO KEEP EXISTING CORRIDORS AND LEASED PREMISES ENTIRELY FREE OF DUST, DEBRIS OR OTHER IMPEDIMENT TO NORMAL USE OF AREAS INVOLVED.
5. THE CONTRACTOR SHALL TAKE ALL PRECAUTIONS TO MAINTAIN FREE ACCESS OF ALL TENANTS, SERVICE PERSONNEL AND THE PUBLIC THROUGH THE AREAS INVOLVED.
6. ALL REUSABLE ITEMS THAT ARE REMOVED AND NOT RELOCATED SHALL BE RETURNED TO THE TENANT FOR STORAGE UNLESS DIRECTED OTHERWISE BY THE TENANT'S REPRESENTATIVE. SALVAGED MATERIALS REQUIRED BY THE TENANT SHALL BE TRANSFERRED TO A MATERIALS STORAGE AREA AS DIRECTED BY THE PORT AUTHORITY ENGINEER.
7. EXISTING VINYL ASBESTOS TILE (VAT) TO REMAIN. DO NOT REMOVE, PROTECT FROM DAMAGE. TYPICAL THROUGHOUT AREA OF WORK.
8. GENERAL CONTRACTOR WILL REPLACE ALL MISSING FIRE PROOFING WHETHER DISTURBED BY GENERAL CONTRACTOR OR NOT.

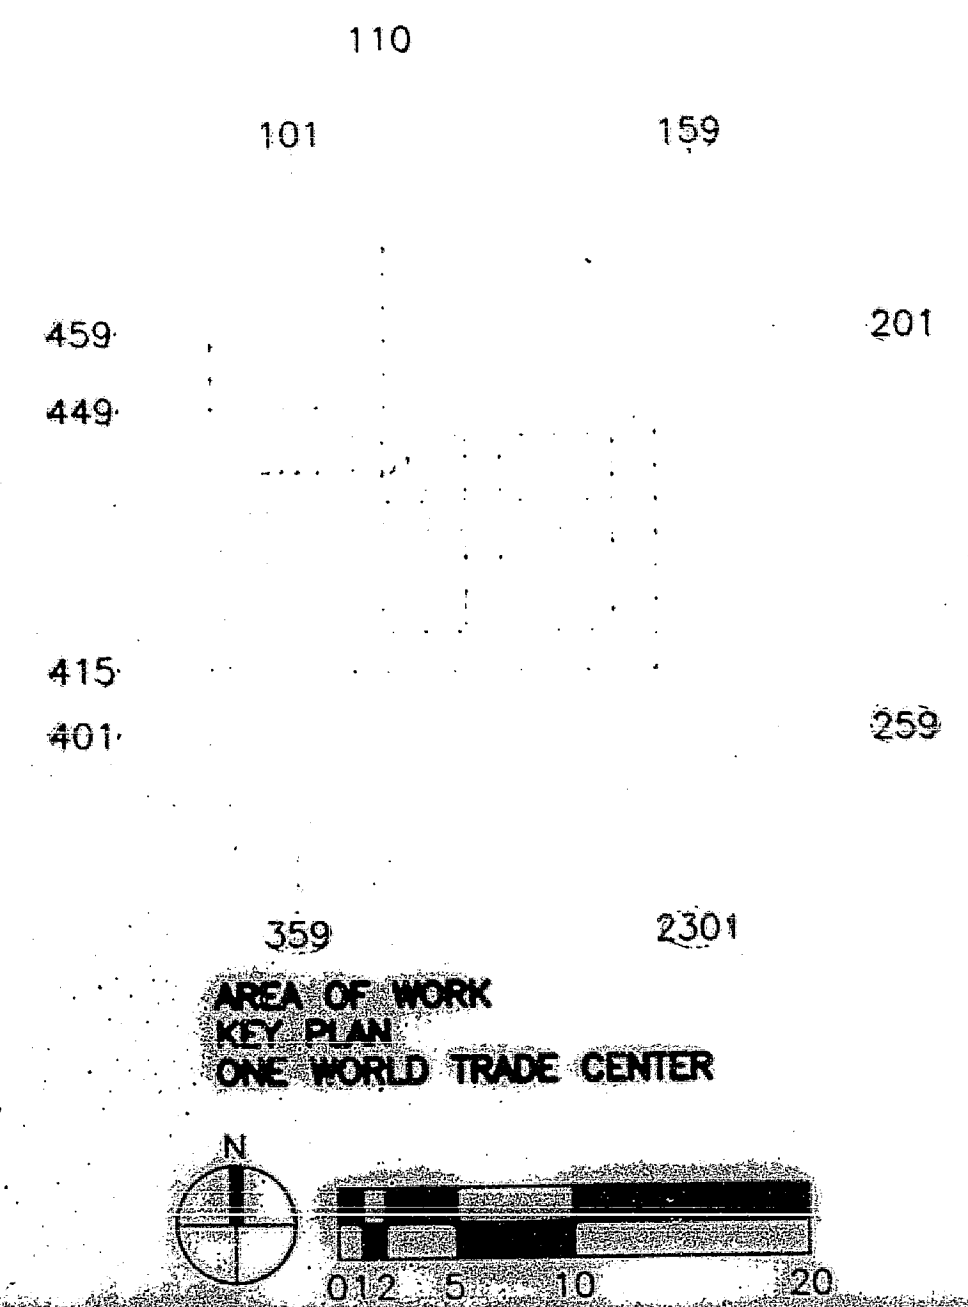

CANTOR FITZGERALD

WHA DESIGN GROUP

Signed: *Ilya Asanovich*
Ilya Asanovich
NIX Interiors Inc.
General Contractor
Certified As-Built

No.	Revision	Issued	Record
1	11.14.94	REVISED AS PER PORT AUTHORITY COMMENTS	SECOND SUBMISSION
2	11.14.94	REVISED AS PER TENANT REQUEST.	11.14.94

Titles

DEMOLITION PLAN

T.A.A. #941154

Scale 1/8" = 1'-0"	Drawn By JP/HR/MH
Project No. 94160	Date 10.10.94
	Dwg. No.

A1.1

FLOOR 105